


This drawing was produced using Leica Disto and Leica Total Station to produce accurate floor plans and elevations and sections.

This is a sample drawing from Fog City Drafting Ltd. It shows an example of our CAD drawing of a commercial building floor plan or external elevation. An Asbuilt drawing of existing conditions.
Our As built's are architectural surveys of existing conditions. We supply CAD drawings in DWG format to Architects and engineers and others who need digital floor plans, sections or elevations for a variety of purposes.

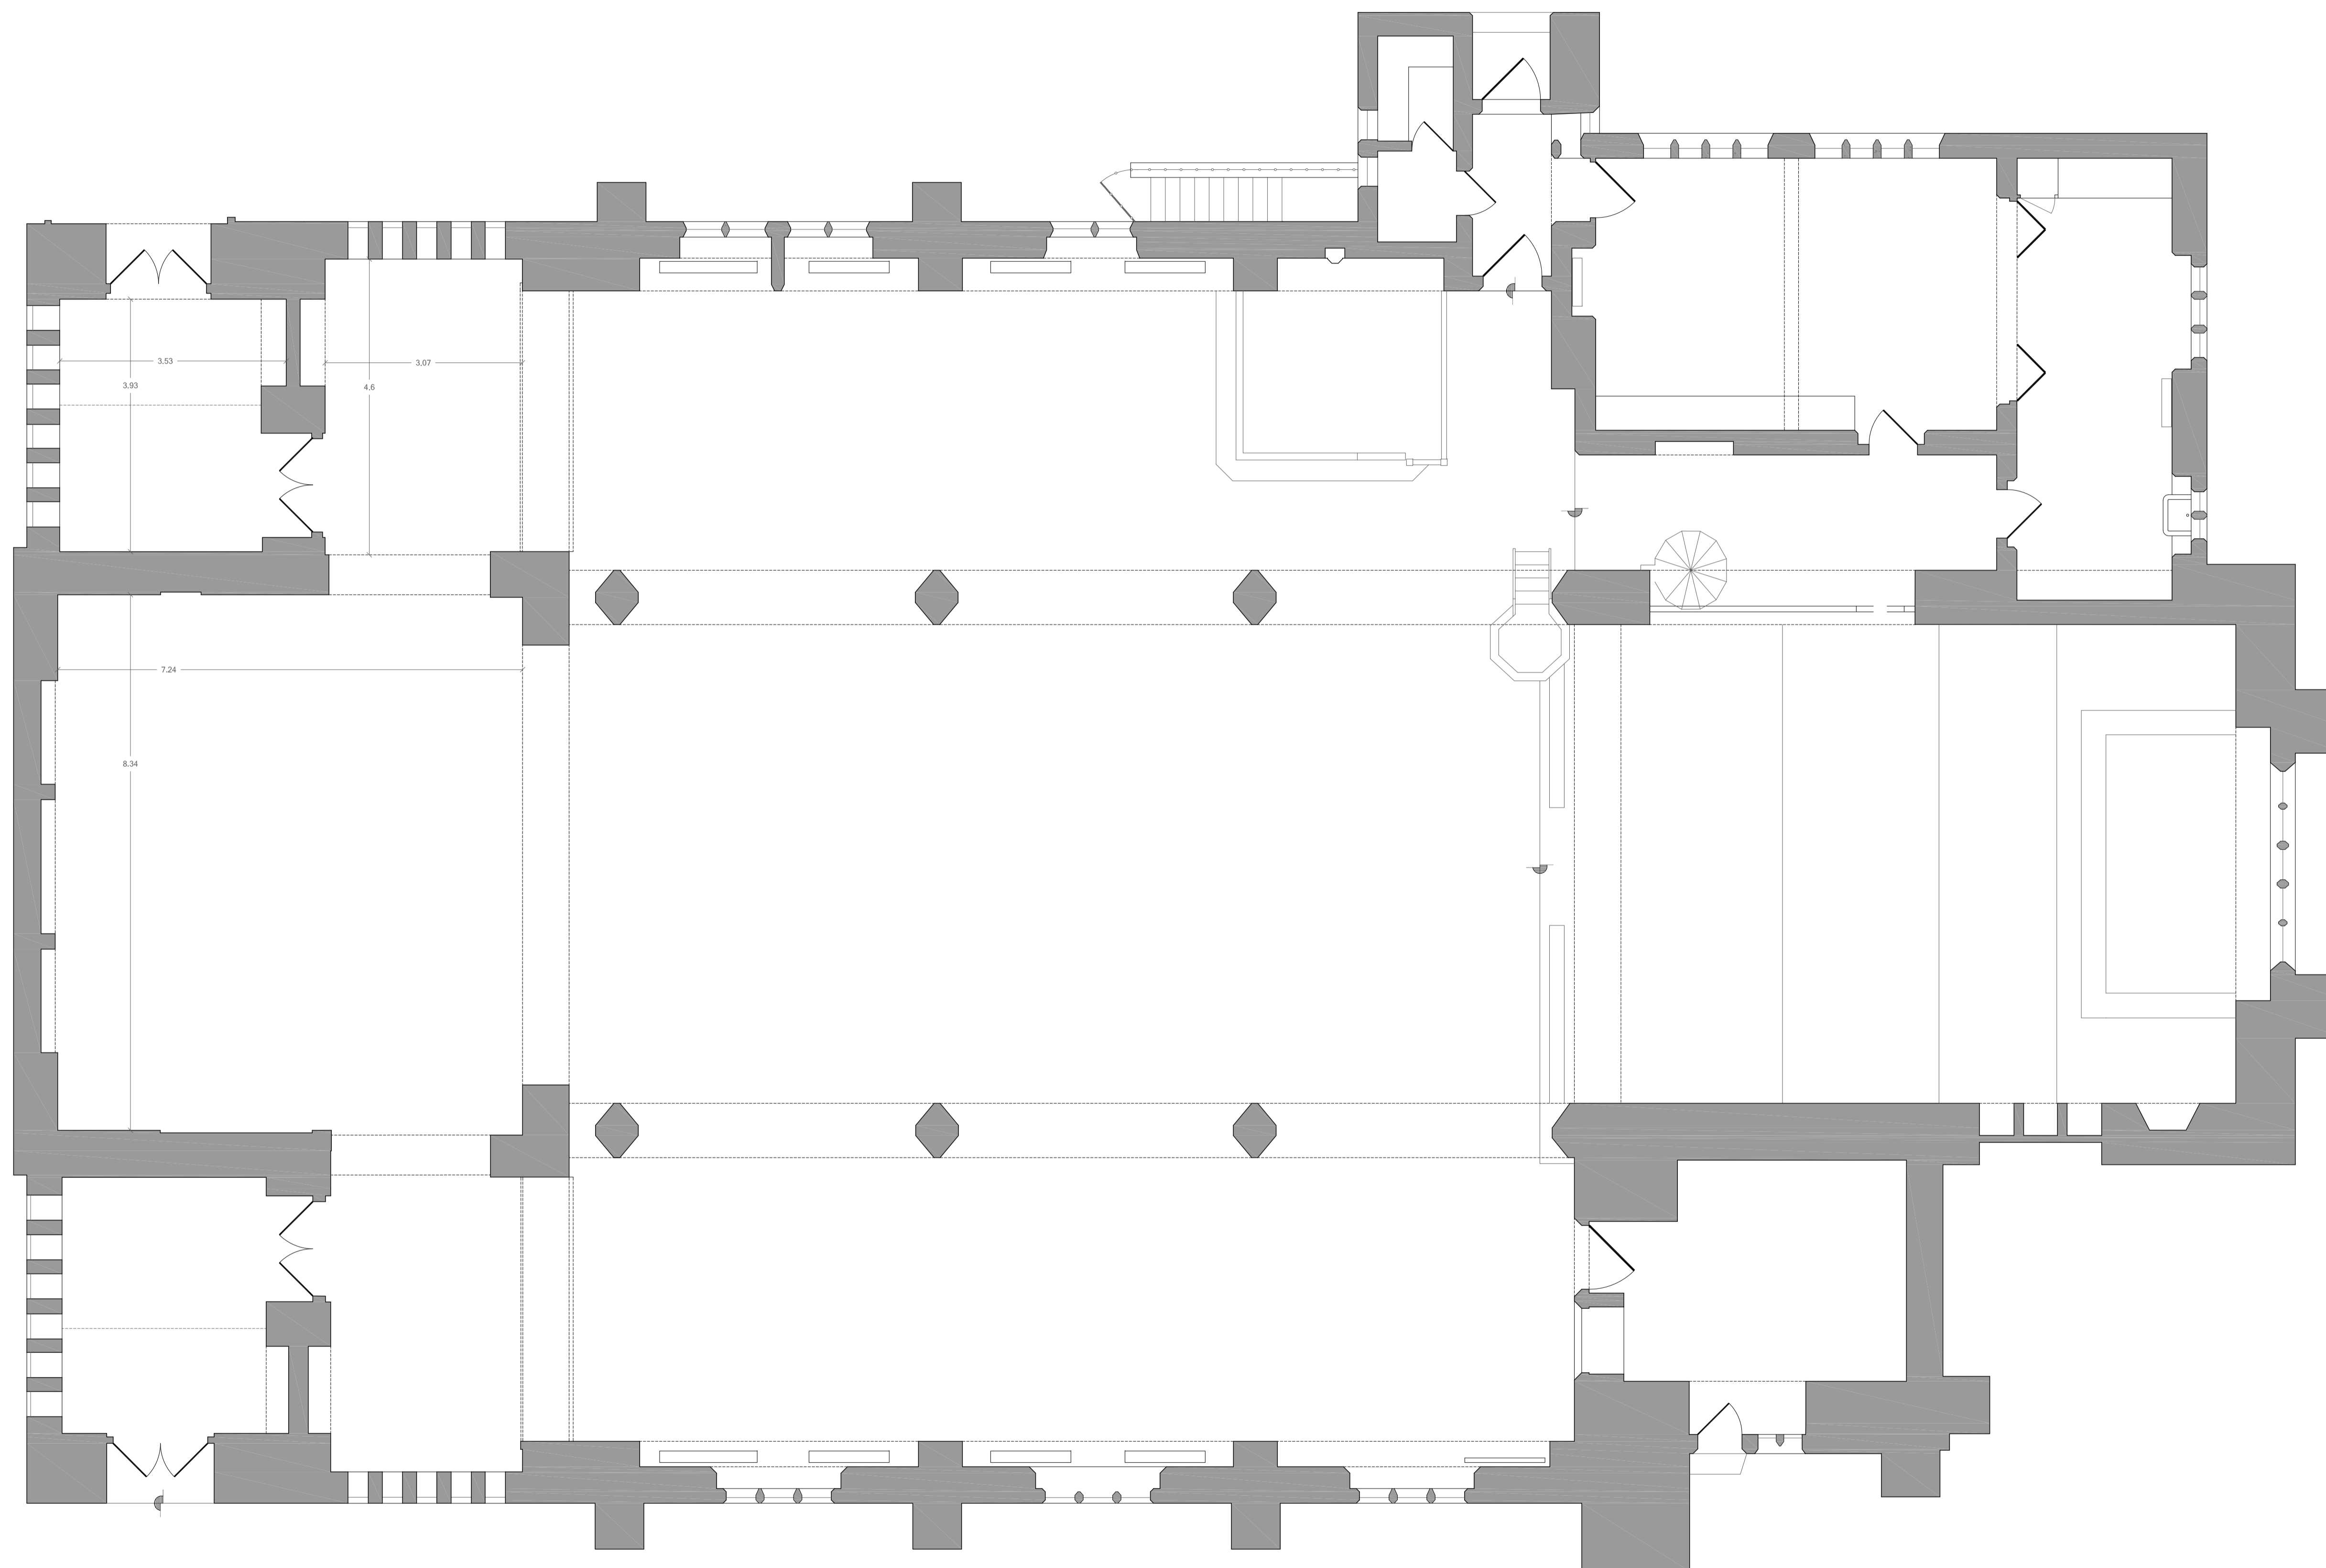

Location - scale 1:1250

Sheet Index

A100		
A101		
A102		
A103		
A104		
A105		
A106		
A107		
A201		
A202		
A203		
A204		
A301		

Rev.	Date	Description
A		

Client

Project
Sample Drawings

Drawing Title
Floor Plan Church

Surveyed & Drawn by



Palworth Lodge,
5a Hillcross Rd,
Bramhall SK7 2BT
0161 439 6574
0800 848 8553
www.fogcitydrafting.co.uk

Drawn By	PFK	Issue Date	2008
Checked by	JPK	Scale	NTS
Drawing No	A100	Revision	A