


This drawing was produced using Leica Disto and Leica Total Station to produce accurate floor plans and elevations and sections.

These are sample drawings from Fog City Drafting Ltd and present examples of our work. FCD produces CAD drawings of commercial and retail buildings. The drawings are suitable for planning purposes and are often used as visual records within lease agreements and for general asset management purposes.

Our As built's are architectural surveys of existing conditions and are used by architects, engineers, property surveyors and others as a record of the structure during the time of survey.

We work nationwide, London, Manchester, Birmingham, Northern Ireland, Isle of White, Scotland, Yorkshire, Merseyside.

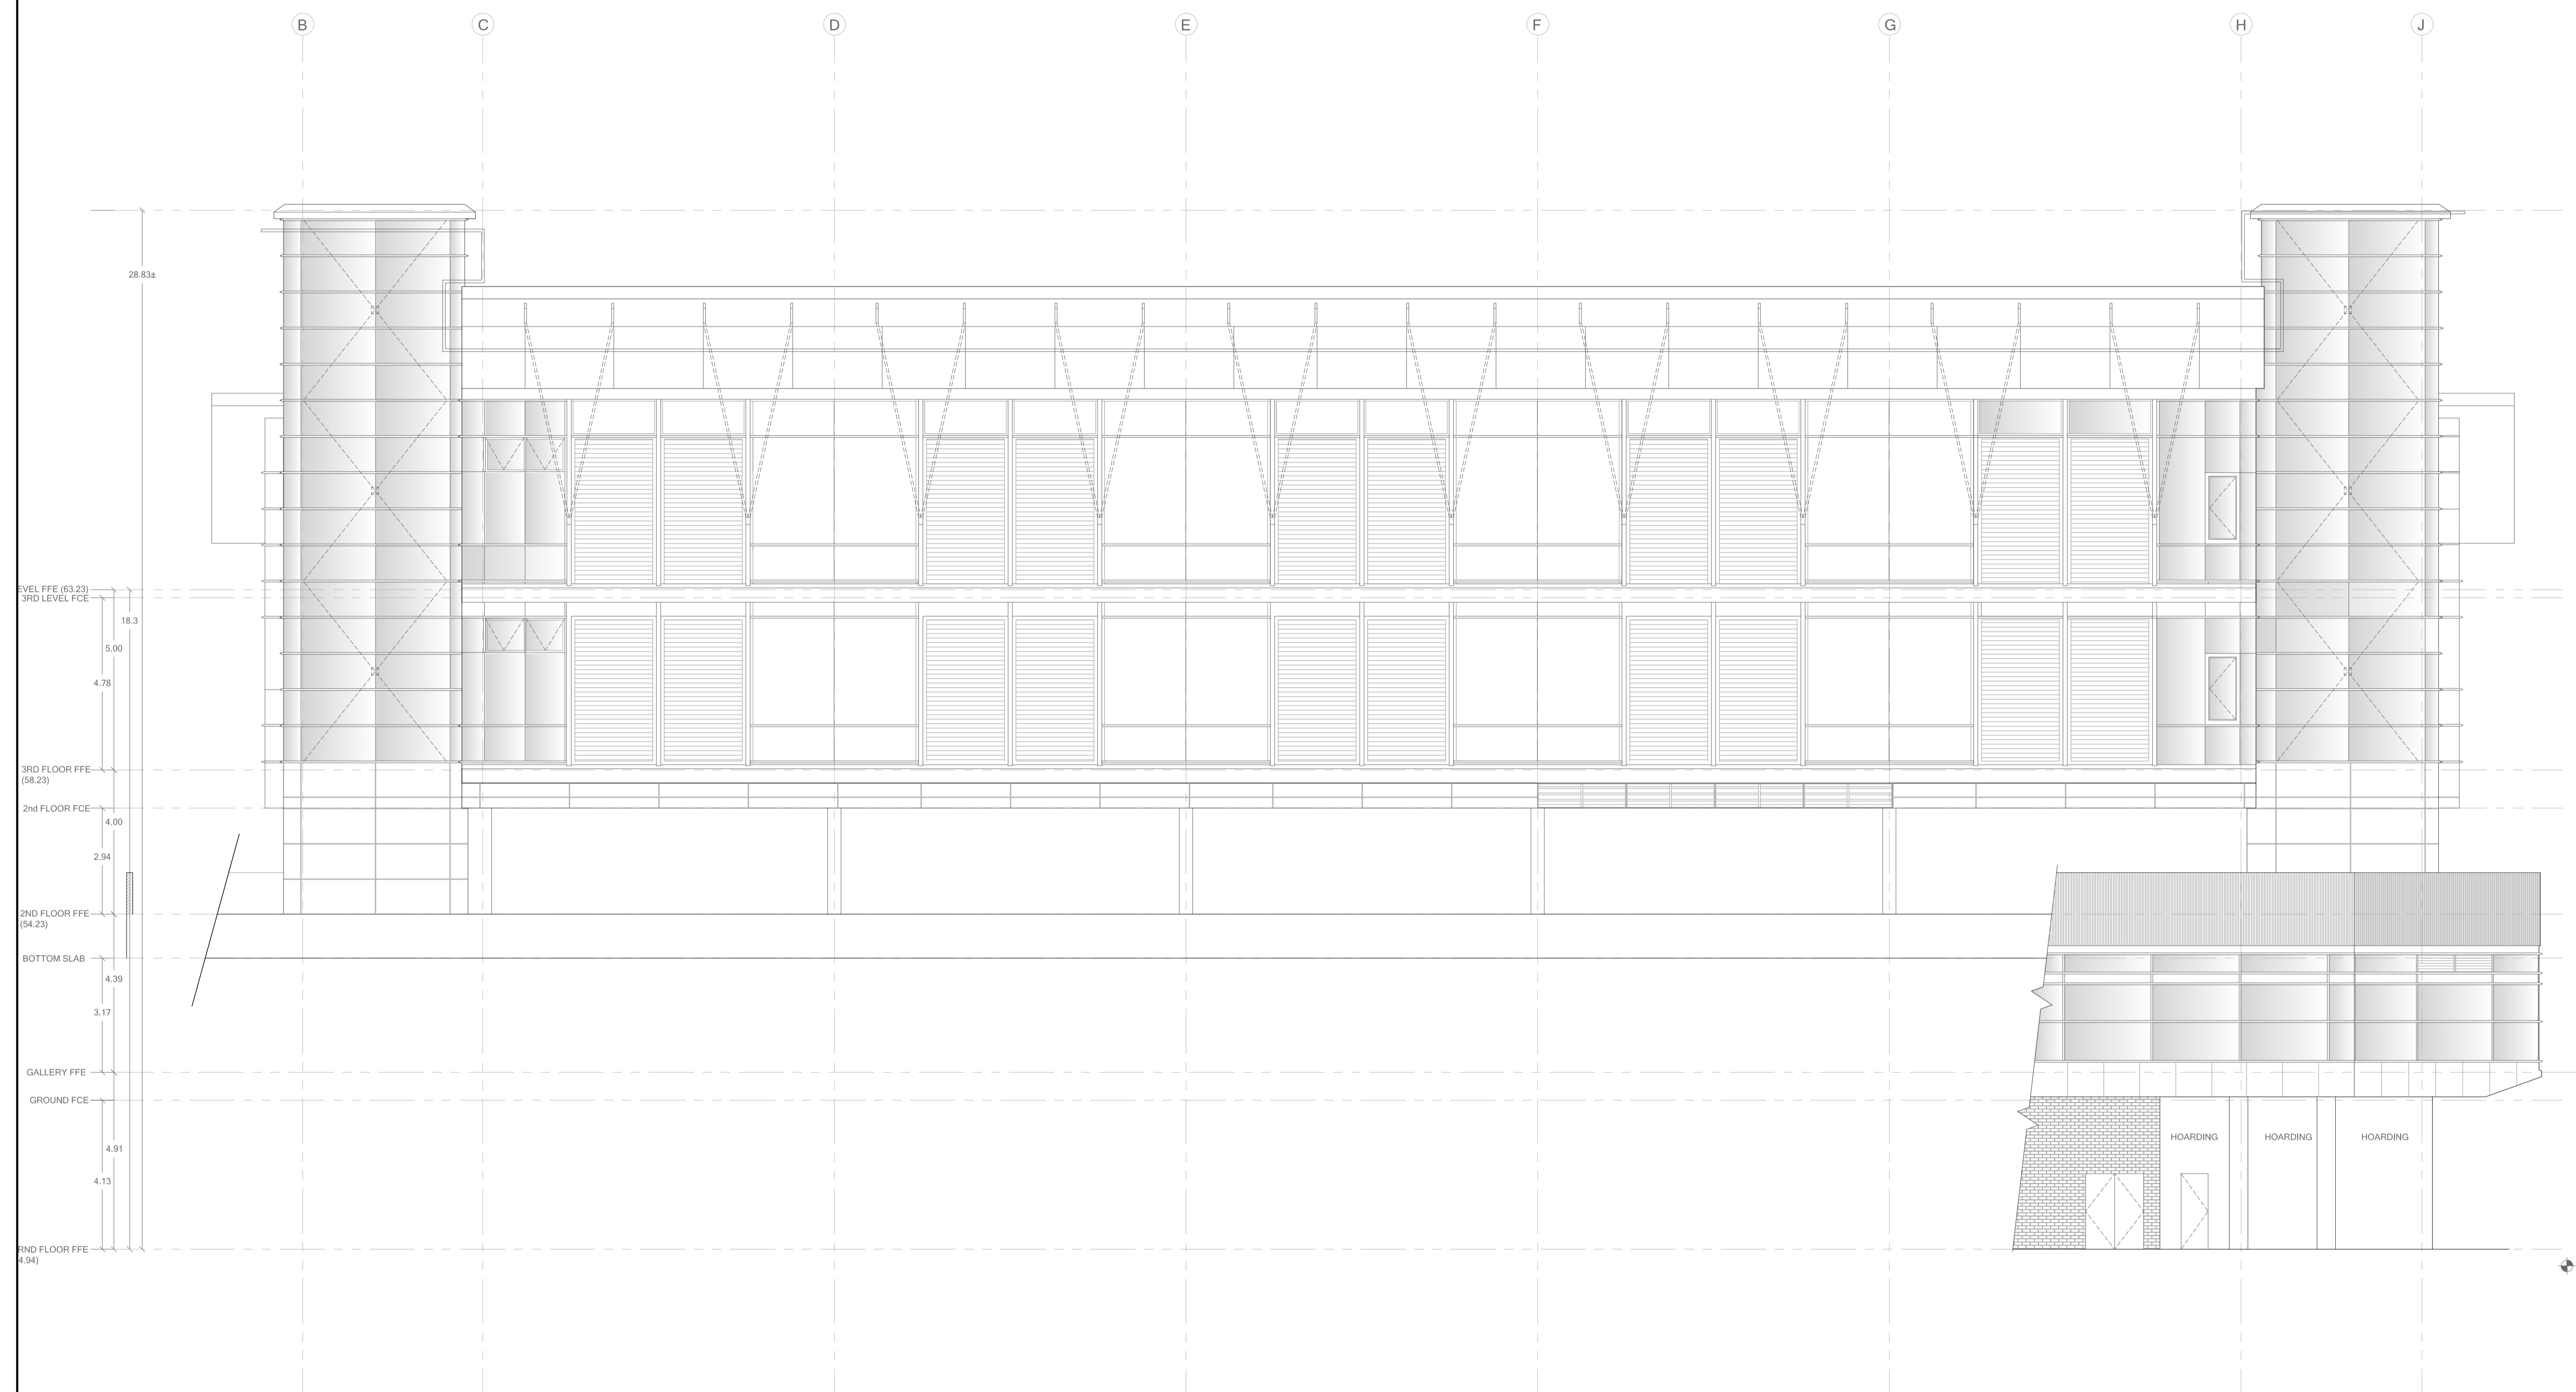

Location - scale 1:1250

Sheet Index

A100	
A101	
A102	
A103	
A104	
A105	
A106	
A107	
A201	
A202	
A203	
A204	
A301	

Rev.	Date	Description
A		

Client

Project
Sample Drawings

Drawing Title
Light Tower

Surveyed & Drawn by

Pulworth Lodge,
1a Millbrook Rd,
Bramhall SK7 2BT
0161 439 4074
0800 848 8563
www.fogcitydrafting.co.uk

Drawn By	PFK	Survey Date	2008
Checked by	JPK	Date	NTS

Drawing No	A100	Revision	A
------------	-------------	----------	----------