


This drawing was produced using Leica Disto and Leica Total Station to produce accurate floor plans and elevations and sections.

This is a sample drawing from Fog City Drafting Ltd. It shows an example of our CAD drawing of a commercial building floor plan or external elevation. An Asbuilt drawing of existing conditions. Our As built's are architectural surveys of existing conditions. We supply CAD drawings in DWG format to Architects and engineers and others who need digital floor plans, sections or elevations for a variety of purposes.

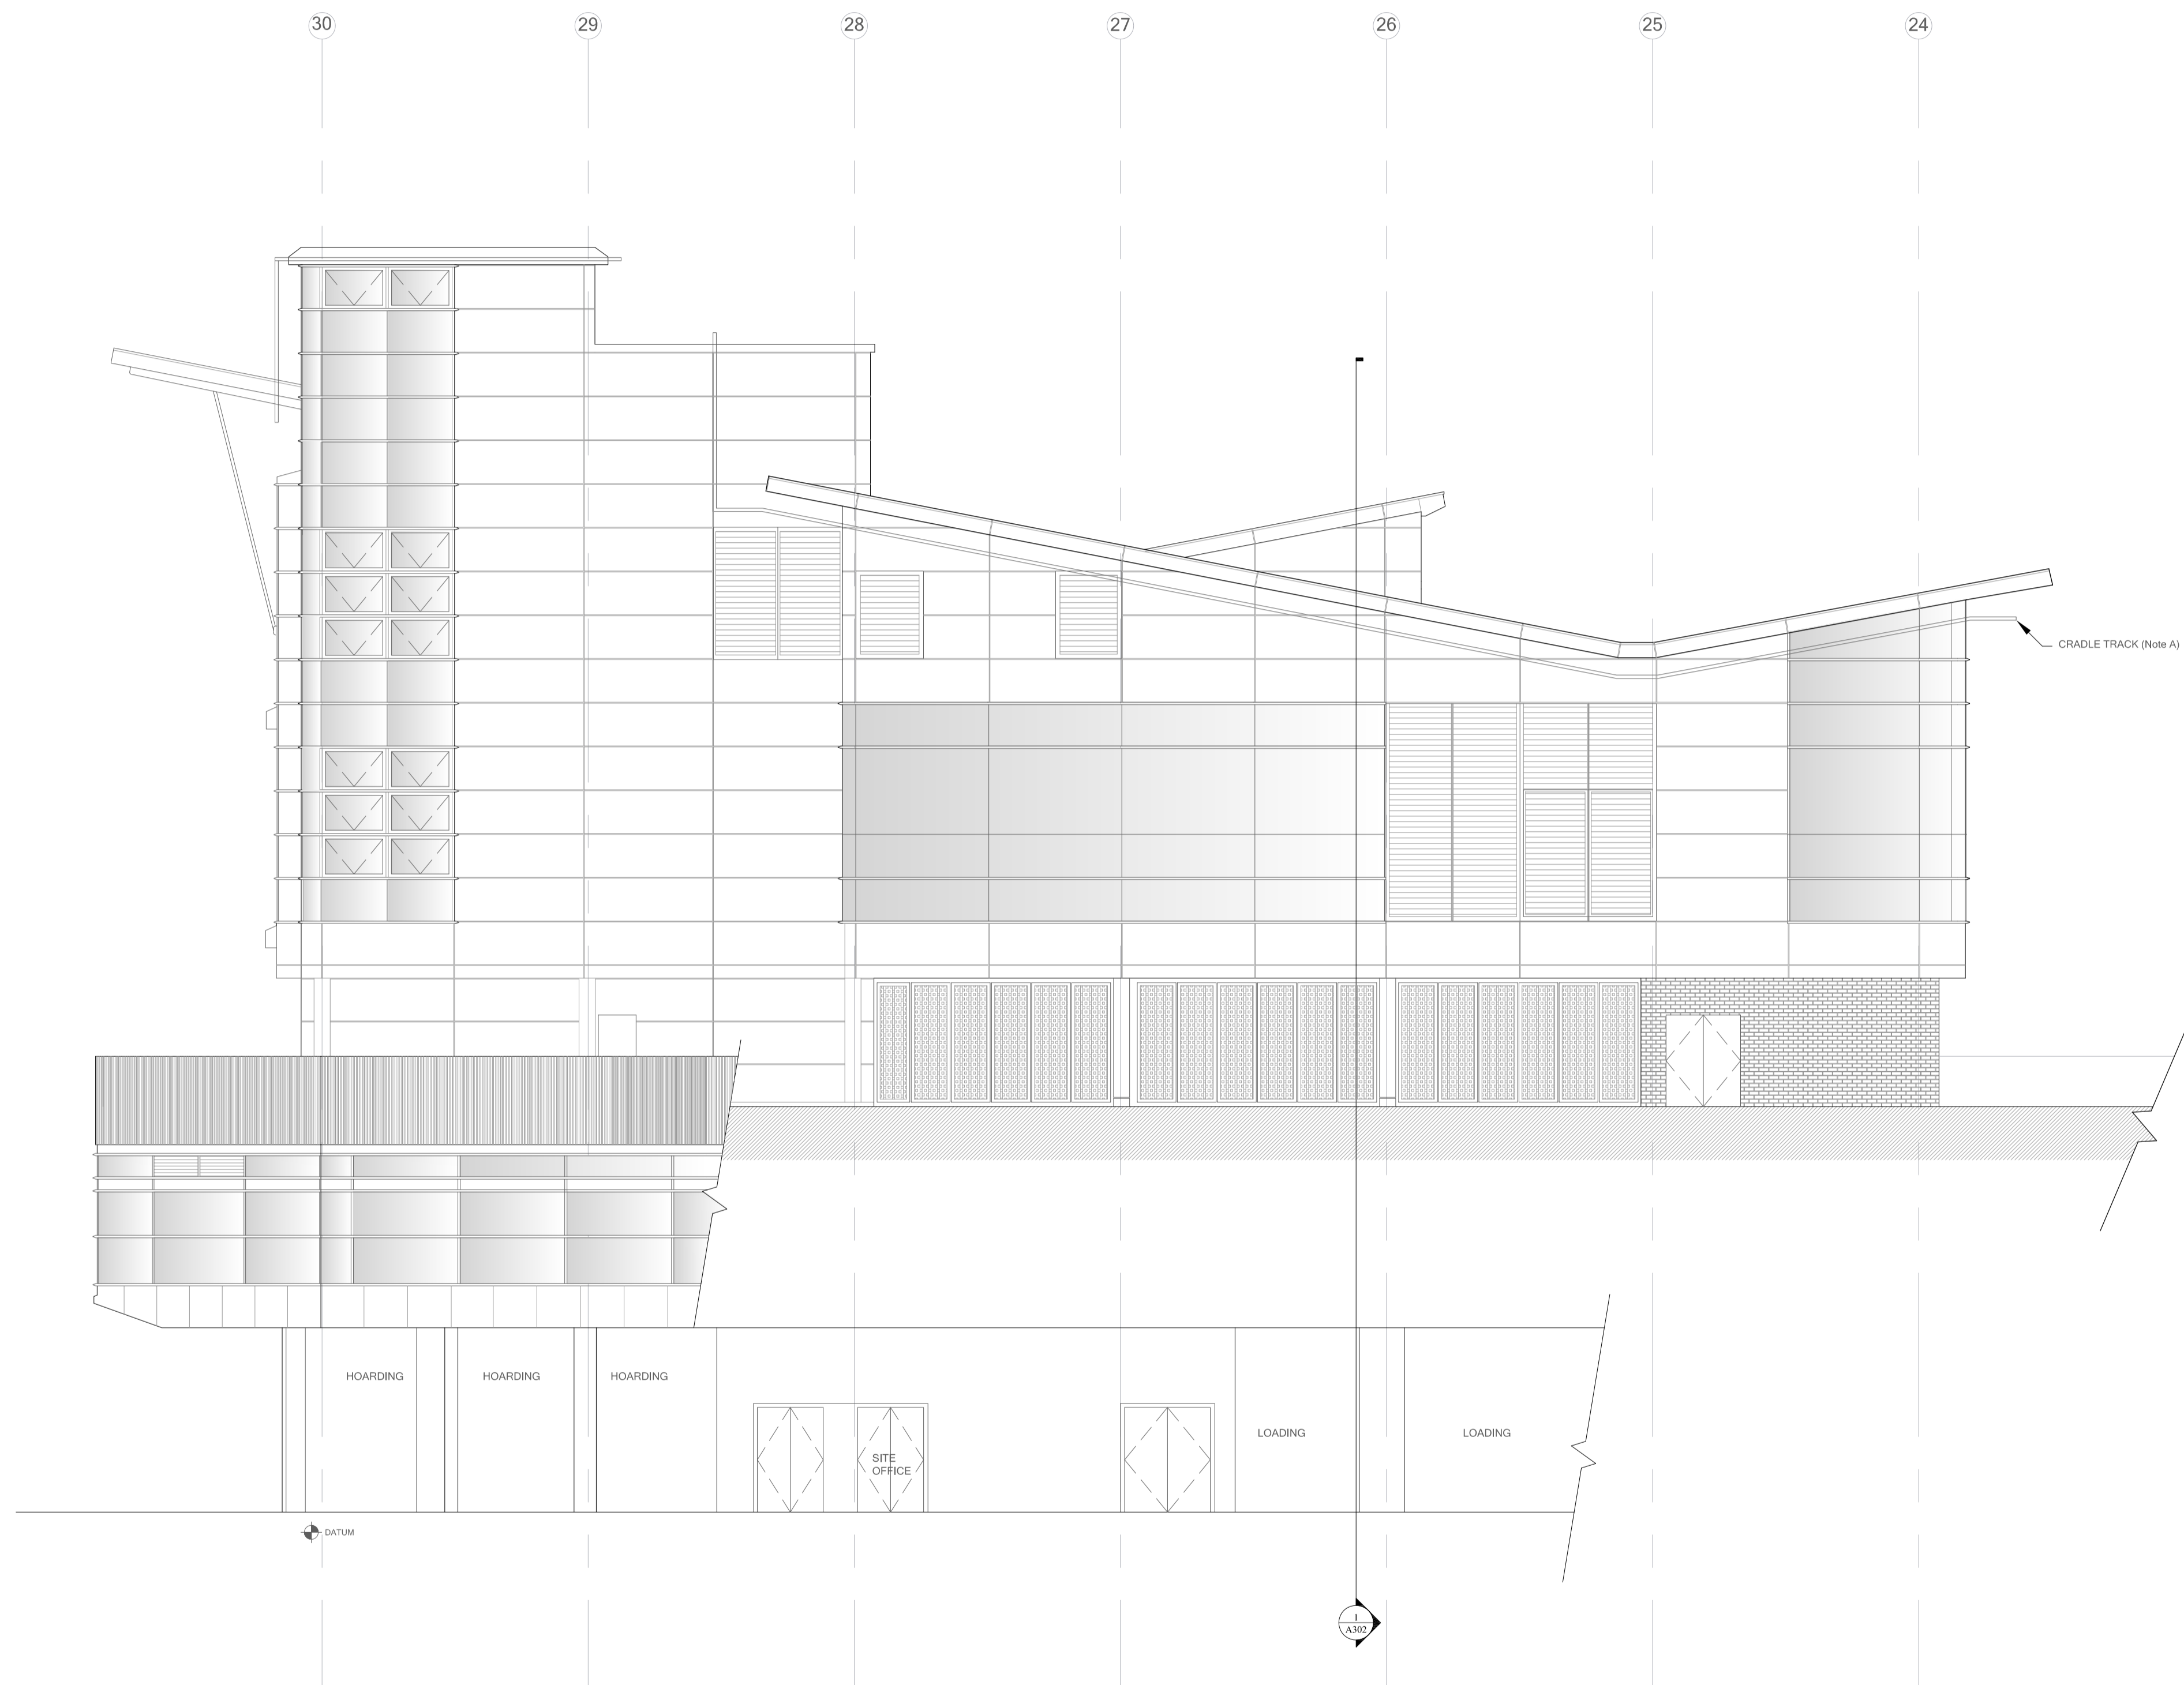

Location - scale 1:1250

Sheet Index

A100	
A101	
A102	
A103	
A104	
A105	
A106	
A107	
A201	
A202	
A203	
A204	
A301	

Rev.	Date	Description
A		

Client

Project  
**Sample Drawings**

Drawing Title  
**Light Tower**

Surveyed & Drawn by



Palworth Lodge,  
5a Hillcross Rd,  
Bramhall SK7 2BT  
0161 438 6574  
0800 848 8553  
www.fogcitydrafting.co.uk

Drawn By	<b>PFK</b>	Issued Date	<b>2008</b>
Checked by	<b>JPK</b>	Scale	<b>1:50</b>

Drawing No	<b>A100</b>	Revision	<b>A</b>
------------	-------------	----------	----------